


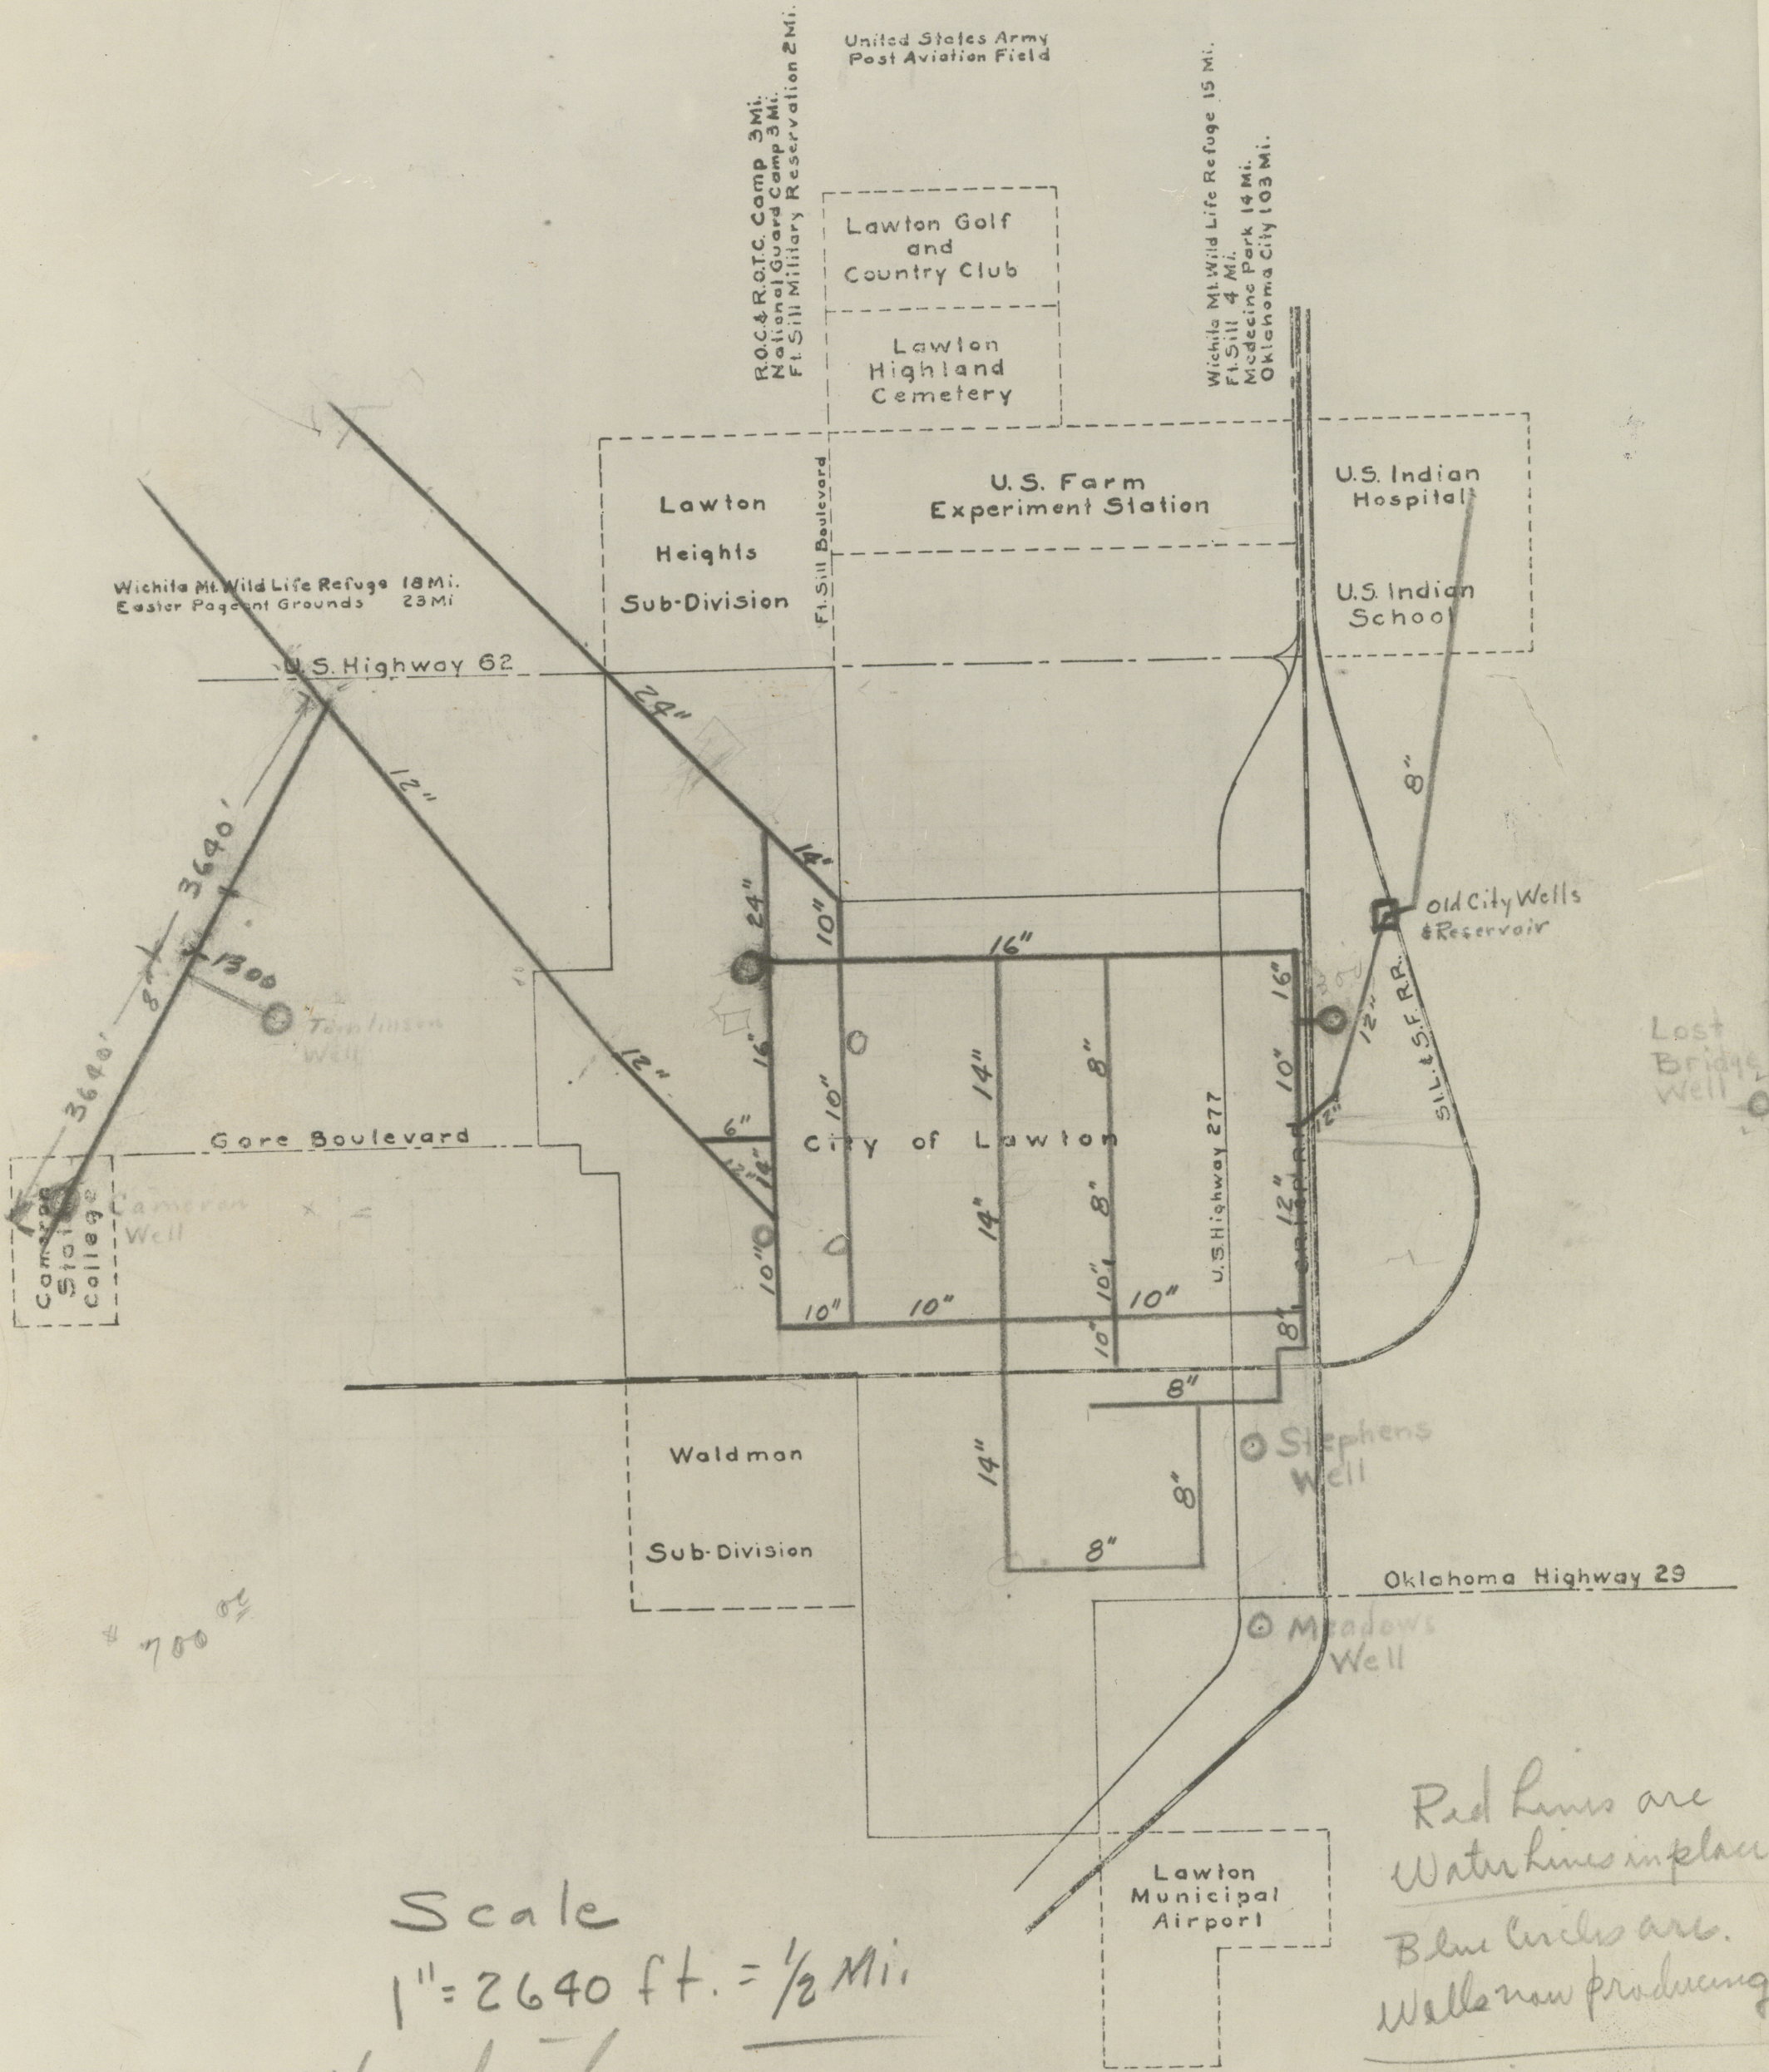

Scale
 1" = 2640 ft. = 1/2 Mi.

W.B. Hendrick
 City Engineer Lawton Okla

Red Lines are
 Water lines in place
 Blue Circles are
 Wells now producing
 Red Circles are storage
 tanks